

**Arcadis UK
2 Craven Court
Willie Snaith Road
Newmarket
Suffolk Cambridgeshire
CB8 7FA**

FAO: James Melrose

Dear Sirs

Location: Saddleworth School High Street Uppermill Oldham OL3 6NU

I acknowledge with thanks your request dated 06/08/14 for information on the location of our services.

Please find enclosed plans showing the approximate position of our apparatus known to be in the vicinity of this site.

I attach General Condition Information sheets, which details contact numbers for additional services (i.e. new supplies, connections, diversions) which we are unable to deal with at this office. In addition you should ensure they are made available to anyone carrying out any works which may affect our apparatus.

I trust the above meets with you requirements and look forward to hearing from you should you need anything further.

If you have any queries regarding this matter please telephone us on 0870 7510101.

Yours Faithfully,



Sue McManus
Operations Manager
Property Searches

United Utilities Water PLC

Property Searches
Ground Floor Grasmere House
Lingley Mere Business Park
Great Sankey
Warrington
WA5 3LP

DX 715568 Warrington

Telephone 0870 751 0101

Fax Number 0870 7510102

Property.searches@uuplc.co.uk

Your Ref: 24838110 - SADDLEWORTH SCH

Our Ref: 14/ 1042404

Date: 08/08/2014

TERMS AND CONDITIONS - WASTERWATER & WATER DISTRIBUTION PLANS

These provisions apply to the public sewerage, water distribution and telemetry systems (including sewers which are the subject of an agreement under Section 104 of the Water Industry Act 1991 and mains installed in accordance with the agreement for the self construction of water mains) (UJW apparatus) of United Utilities Water PLC ("UJW").

TERMS AND CONDITIONS:

1. This Map and any information supplied with it is issued subject to the provisions contained below, to the exclusion of all others and no party relies upon any representation, warranty, collateral contract or other assurance of any person (whether party to this agreement or not) that is not set out in this agreement or the documents referred to in it.
2. This Map and any information supplied with it is provided for general guidance only and no representation, undertaking or warranty as to its accuracy, completeness or being up to date is given or implied.
3. In particular, the position and depth of any UJW apparatus shown on the Map are approximate only. UJW strongly recommends that a comprehensive survey is undertaken in addition to reviewing this Map to determine and ensure the precise location of any UJW apparatus. The exact location, positions and depths should be obtained by excavation trial holes.
4. The location and position of private drains, private sewers and service pipes to properties are not normally shown on this Map but their presence must be anticipated and accounted for and you are strongly advised to carry out your own further enquiries and investigations in order to locate the same.
5. The position and depth of UJW apparatus is subject to change and therefore this Map is issued subject to any removal or change in location of the same. The onus is entirely upon you to confirm whether any changes to the Map have been made subsequent to issue and prior to any works being carried out.
6. This Map and any information shown on it or provided with it must not be relied upon in the event of any development, construction or other works (including but not limited to any excavations) in the vicinity of UJW apparatus or for the purpose of determining the suitability of a point of connection to the sewerage or other distribution systems.
7. No person or legal entity, including any company shall be relieved from any liability howsoever and whensoever arising for any damage caused to UJW apparatus by reason of the actual position and/or depths of UJW apparatus being different from those shown on the Map and any information supplied with it.
8. If any provision contained herein is or becomes legally invalid or unenforceable, it will be taken to be severed from the remaining provisions which shall be unaffected and continue in full force and affect.
9. This agreement shall be governed by English law and all parties submit to the exclusive jurisdiction of the English courts, save that nothing will prevent UJW from bringing proceedings in any other competent jurisdiction, whether concurrently or otherwise.

Extract from Map of Public Sewers

The position of underground apparatus shown on this plan is approximate only and is given in accordance with the best information currently available.

The actual positions may be different from those shown on the plan and private pipes, sewers or drains may not be recorded.

United Utilities will not accept any liability for any damage caused by the actual positions being different from those shown.

United Utilities 2001

The plan is based upon the Ordnance Survey Map with the sanction of the Controller of H.M. Stationery Office. Crown and United Utilities copyrights are reserved. Unauthorised reproduction will infringe these copyrights.

LEGEND


	Water Course
	Overflow Pipe
	Sludge Main
	Highway Drain
	Combined
	Surface Water
	Foul
	Abandoned
	Public Sewer
	Private Sewer
	Section 104
	Rising Main

Saddleworth School
High Street
Uppermill, Oldham

Printed By : Liz Bywater

Date: 08/08/2014

DO NOT SCALE
Approximate Scale: 1:1250

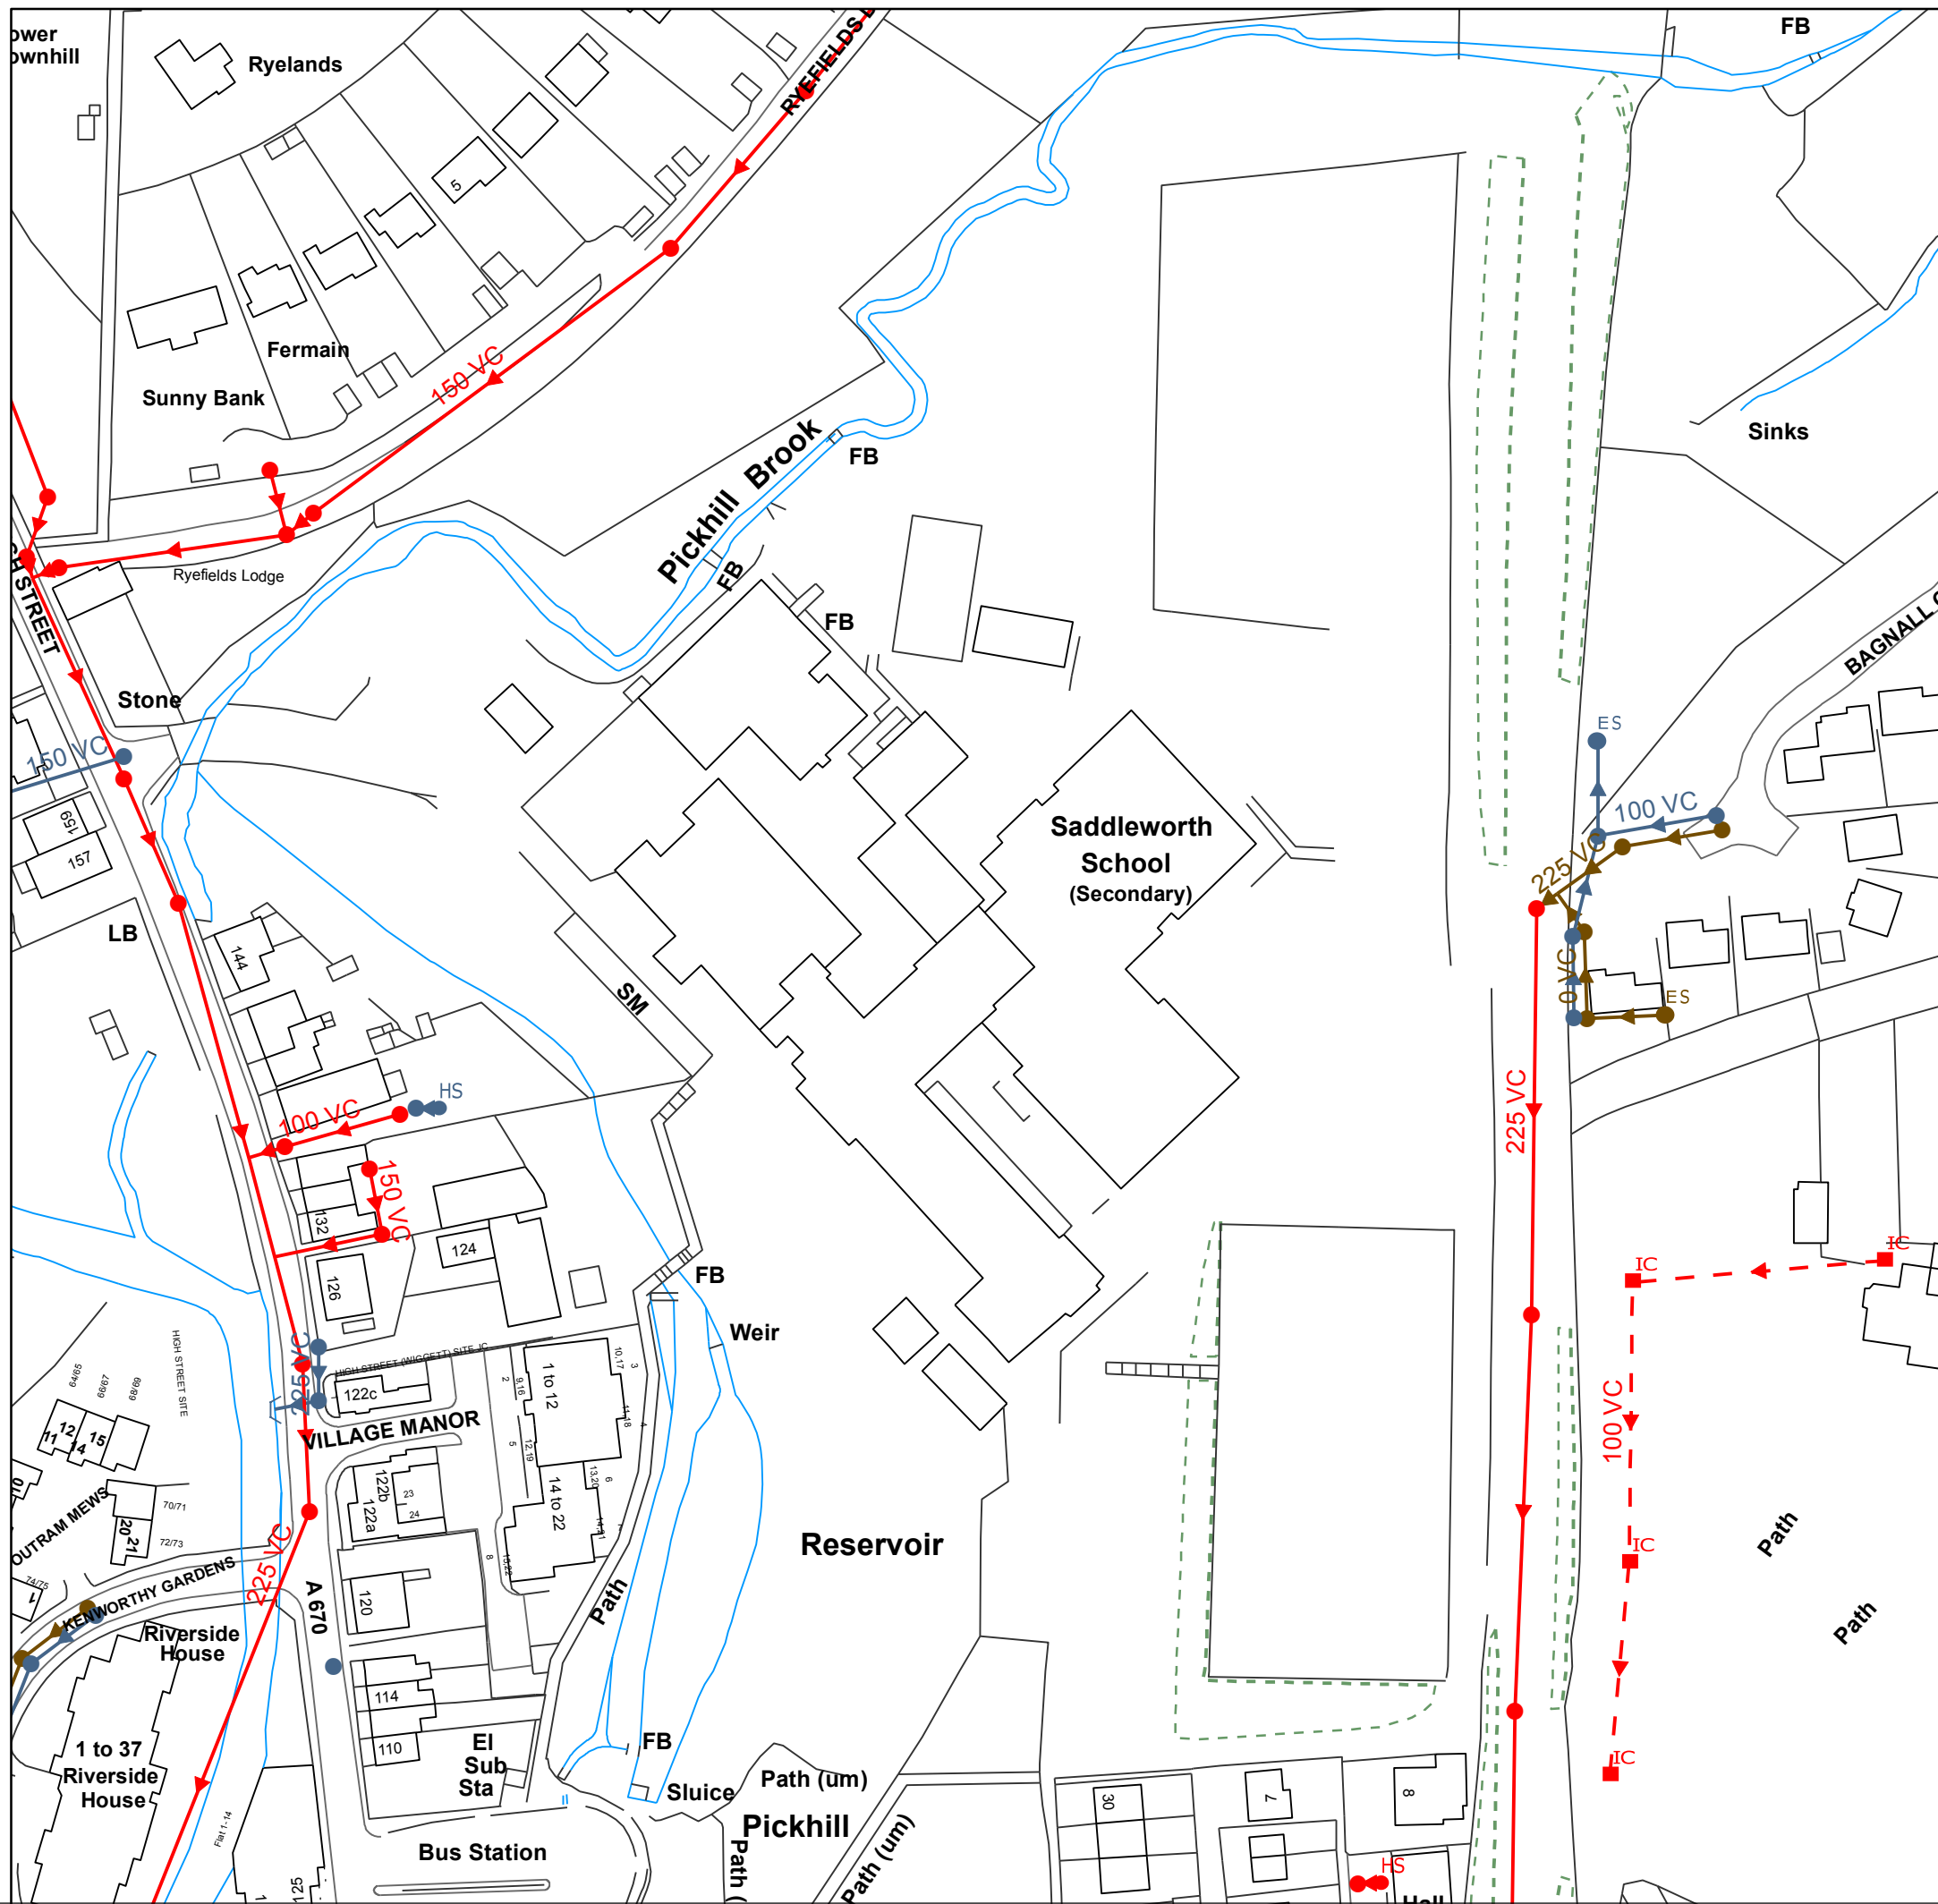

Extract from Map of Water Mains

The position of underground apparatus shown on this plan is approximate only and is given in accordance with the best information currently available.

The actual positions may be different from those shown on the plan and private pipes, sewers or drains may not be recorded.

United Utilities will not accept any liability for any damage caused by the actual positions being different from those shown.

United Utilities 2001
 The plan is based upon the Ordnance Survey Map with the sanction of the Controller of H.M. Stationery Office. Crown and United Utilities copyrights are reserved. Unauthorised reproduction will infringe these copyrights.

LEGEND


Proposed	Abandoned	Live	
			Distribution Main
			Trunk Main
			Comms Pipe
			Private Pipe
			Raw Water
			LDTM Raw Water
			LDTM Treated Water

Saddleworth School
 High Street
 Uppermill, Oldham

Printed By : Liz Bywater

Date: 08/08/2014

DO NOT SCALE
 Approximate Scale: 1:1250

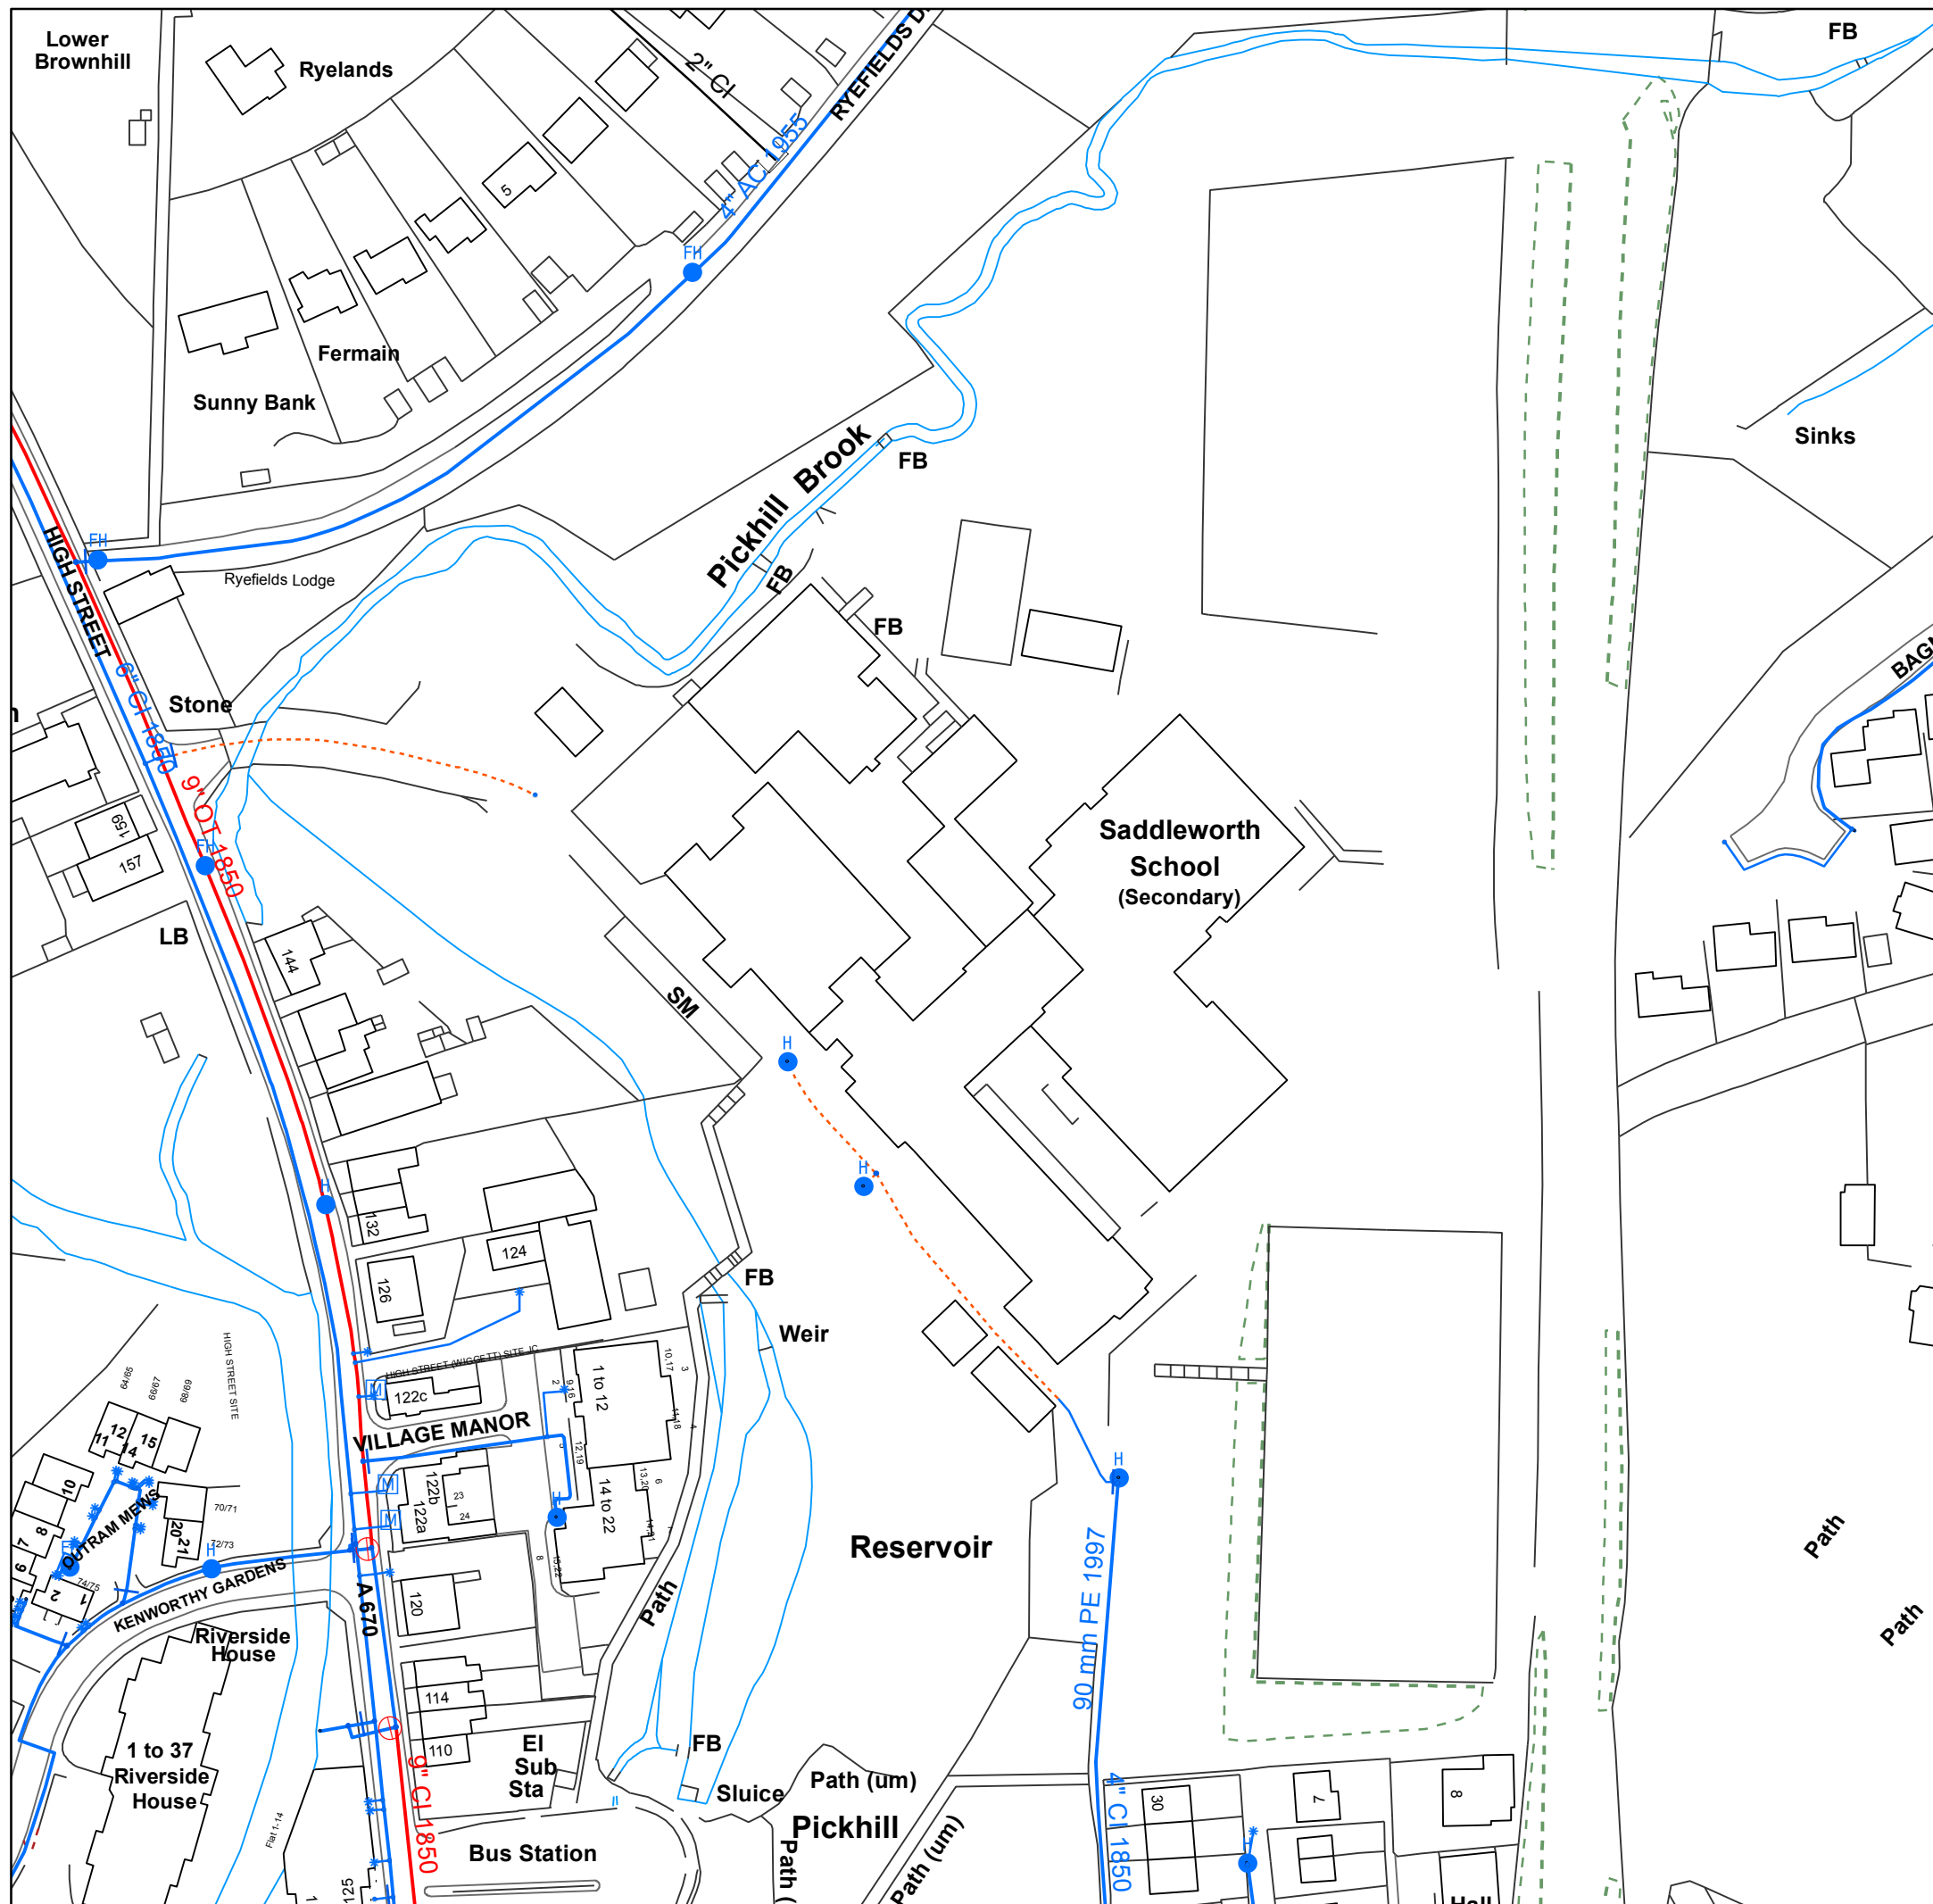

These general conditions and precautions apply to the water distribution system of United Utilities.

Please ensure that a copy of these conditions is passed to your representative and contractor on site.

1. United Utilities provides approximate locations of its water mains or apparatus according to its records. These records are not necessarily accurate or complete nor do they normally show the positions of private service pipes from the mains to properties. Where service pipes are shown, a blue broken line indicates their approximate position. No person or company shall be relieved from liability for any damage caused by reason of the actual positions and/or depths being different from those indicated.

2. Special requirements relative to our apparatus may be indicated. United Utilities employees will visit any site at reasonable notice to assist in the location of its underground water apparatus and advise any precautions that may be required to obviate any damage. To arrange a visit or for further information regarding new supplies, connections, diversions, costing, future proposals for construction of company apparatus or any notification required under these General Conditions, please telephone us on **0845 746 2200** or write to United Utilities, PO Box 453, Warrington, WA5 3QN.

3. In order to achieve safe working conditions adjacent to any water apparatus the following should be observed;

(a) All water apparatus should be located by hand digging prior to the use of mechanical excavation.

(b) During construction work where heavy plant may have to cross the line of a water main, and the main is not under a carriageway of adequate standard of construction, crossing points should be suitably reinforced with sleepers, steel plates or a specially constructed reinforced concrete raft as necessary. These crossing points should be clearly indicated and crossing the line of the water main at other places should be prevented. United Utilities employees will advise on the type of reinforcement necessary. This is particularly important on agricultural or open land, where tilling or erosion may have significantly reduced the original cover.

(c) No explosive should be used within 32 metres of any United Utilities apparatus without prior consultation with United Utilities.

(d) Where it is proposed to carry out piling within 15 metres of any water main United Utilities should be consulted so that the affected main may be surveyed.

4. During any excavation, it is important that measures should be taken to ensure continued support for any water main:

(a) Where excavation of trenches adjacent to any water main is likely to affect its support, the main must be supported to the satisfaction of United Utilities.

(b) Where a trench is excavated crossing or parallel to the line of a water main, the backfill should be adequately compacted to prevent any settlement which could subsequently cause damage to the main. In special cases it may be necessary to provide permanent support to a main which has been exposed over the length of the excavation before back-filling and reinstatement is carried out. No back-filled concrete should contact the main.

5. No other apparatus should be laid over and along the line of a water main irrespective of clearance. A minimum clearance of 450 millimetres should be allowed between any plant being installed and an existing main, to facilitate maintenance and repair, whether the adjacent plant is parallel to or crossing the main. No manhole, chamber, or other obstruction should be built over or around a water main.

6. Where a water main is coated with special wrapping and the wrapping is damaged, even to a minor extent, United Utilities must be notified, and the excavation must be left open for ready access so that repairs can be made. In case of any material damage to the main itself causing leakage, or weakening of the mechanical strength of the pipe, the person or body responsible should immediately notify United Utilities in order that the necessary remedial work can be carried out. The full cost of the necessary remedial work will be charged to the person or body responsible for the damage.

7. If you propose to change existing levels over water mains you will need to inform us. We will need specific locations to be identified together with precise details as to the scale of the proposed changes to existing ground levels. Changes to existing levels may require the diversion of our apparatus at your cost. However, in certain circumstances we may wish to leave our apparatus where it is. On these occasions you will usually be required to protect our apparatus by means of a concrete raft and either raise or lower any surface boxes affected.

8. Under no circumstances should our surface boxes be either buried or left in a situation where they are raised above finished ground levels. You should re-use and re-set any surface boxes affected by your works into the new surface so that they align over the water apparatus below. You will be responsible for the cost of repairing any damage to our apparatus as a result of your works.

9. Where proposals involve resurfacing, you must notify United Utilities if your excavation will be greater than 750mm in the highway and 300mm in a footpath, verge or other location.

10. For information regarding easements, deeds, grants, licences or wayleaves, please write to United Utilities Property Solutions, Coniston Buildings, Lingley Mere Business Park, Lingley Green Avenue, Great Sankey, Warrington WA5 3UU (Tel 01925 731 365).

Tree planting restrictions over water mains

a) Poplar and willow trees have extensive root systems and should not be planted within 10 metres of any water main.

b) The following trees and those of a similar size, whether they are deciduous or evergreen, should not be planted within six metres of any water main:

- Ash, beech, birch, elm, horse chestnut, lime, oak, sycamore;
- Apple trees and pear trees;
- Most conifers.

c) United Utilities requires access to the route of its mains at all times to inspect for leaks and carry out surveys.

We recommend that no shrubs or bushes which might obstruct or interfere with our access should be planted within one metre of the centre line of any water main.

d) There may be instances when both United Utilities and the landowner will wish to plant shrubs or bushes close to the water main for screening or other purposes. The following shallow rooting shrubs would be suitable for this purpose:

- Blackthorn, broom, cotoneaster, elder;
- Hazel, laurel, privet, quickthorn, snowberry;
- Most ornamental flowering shrubs.

e) In areas where soft fruit is grown, blackcurrant, raspberries and gooseberries may be planted close to the main, provided that a path is left clear for inspection access and surveys. United Utilities can give additional advice where required in particular circumstances.

These general conditions and precautions apply to the wastewater network of United Utilities.

Please ensure that a copy of these conditions is passed to your representative and contractor on site.

1. United Utilities provides the approximate locations of its sewers according to its records. These records are not necessarily accurate or complete nor do they normally show the positions of every sewer culvert or drain, private connections from properties to the public sewers or the particulars of any private system. No person or company shall be relieved from liability for any damage caused by reason of the actual positions and/or depths being different from those indicated. The records do indicate the position of the nearest known public sewer from which the likely length of private connections can be estimated together with the need for any off site drainage rights or easements.
 2. Special requirements relative to our sewers may be indicated. United Utilities employees or its contractors will visit any site at reasonable notice to assist in the location of its underground sewers and advise any precautions that may be required to obviate any damage. To arrange a visit or for further information regarding new supplies, connections, diversions, costing, or any notification required under these General Conditions, please call us on **0845 746 2200**.
 3. Where public sewers are within a site which is to be developed and do not take any drainage from outside the area, they are from an operational viewpoint redundant. The developer must identify all redundant sewers affected by the development and apply to United Utilities in writing for these sewers to be formally closed. The developer shall bear all related costs of the physical abandonment work.
 4. Public sewers within the site that are still live outside the area will be subject to a "Restricted Building zone". This would normally be a surface area equivalent to the depth of the sewer measured from the centre line of the sewer on either side. No construction will be permitted within that zone. The developer should also note that deep and wide rooted trees must not be planted in close proximity to live sewers. Access to public sewers must be maintained at all times and no interference to manholes will be permitted during construction work.
1. Where there is a public sewer along the line of a proposed development/building, arrangements shall be made by the developer at his cost to divert the sewer around the development. Where this is not possible and as a last resort, a "Building Over Agreement" will need to be completed under section 18 of the Building Act 1984. The developer shall design building foundations to ensure that no additional loading is transferred to the sewer and submit such details both to the Local Authority's Building Control Officer and to United Utilities for approval/acceptance. United Utilities on a rechargeable basis would normally undertake all aspects of design work associated with the diversion of any part of the operational wastewater network. For further advice please email wastewaterdeveloperservices@uuplc.co.uk
 2. Where there is a non-main river watercourse/culvert passing through the site, the landowner has the responsibility of a riparian owner for the watercourse/culvert and is responsible for the maintenance of the fabric of the culvert and for all works involved in maintaining the unrestricted flow through it. Building over the watercourse/culvert is not recommended. The developer must contact the local authority before any works are carried out on the watercourse/culvert. Where it is necessary to discharge surface water from the site into the watercourse/culvert the developer shall make an assessment of the available capacity of the watercourse/culvert (based on a 1 in 50 year event) and ensure that the additional flow to be discharged into the watercourse/culvert will not cause any flooding. In appropriate cases, flooding may be prevented by on-site storage. The developer shall submit the relevant details required to substantiate his development proposals. Details of any outfall proposed shall also be submitted to the Environment Agency, PO Box 12, Richard Fairclough House, Knutsford Road, Warrington, Cheshire, WA4 1HT for their approval.
 3. Where there is a main river watercourse/culvert passing through the site, the developer shall submit all proposals affecting the river to the Environment Agency at the address stated in paragraph 6 for approval/acceptance.

8. Your attention is drawn also to the following:

• **Private drains or sewers which may be within the site.**

On 1 October 2011 all privately owned sewers and lateral drains which communicate with (that is drain to) an existing public sewer as at 1 July 2011 will become the responsibility of the sewerage undertaker. This includes private sewers upstream of pumping stations that have yet to transfer, but excludes lengths of sewer or drain that are the subject of an on-going appeal or which have been excluded from transfer as a result of an appeal or which are on or under land opted-out by a Crown body. The transfer specifically excludes sewers and lateral drains owned by a railway undertaker. Sewers upstream of such assets, however, are transferred. Such assets may not be recorded on the public sewer record currently as it was not a requirement to keep records of previously private sewers and drains.

• **Applications to make connections to the public sewer.**

The developer must write to United Utilities requesting an application form that must be duly completed and returned. No works on the public sewer shall be carried out until a letter of consent is received from United Utilities.

• **Sewers for adoption.** If an agreement for the adoption of sewers under Section 104 of the Water Industry Act 1991 is being contemplated, a submission in accordance with "Sewers for Adoption", Seventh Edition, published by the Water Research Centre (2001) Plc, Henley Road, Medmenham, PO Box 16, Marlow, Buckinghamshire, SL7 2HD will be required, taking into consideration any departures from the general guide stipulated by United Utilities.

• **Further consultation with United Utilities.**

Developers wishing to seek advice or clarification regarding sewer record information provided should contact United Utilities to arrange an appointment. A consultation fee may be charged, details of which will be made available at the time of making an appointment.

9. Combined sewers, foul sewers, surface water sewers, and pumped mains. These are shown separately in a range of colours or markings to distinguish them on our drawings, which are extracts from the statutory regional sewer map. A legend and key is provided on each extract for general use, although not all types of sewer will be shown on every extract.

Combined sewers shown coloured red carries both surface water and foul sewage, especially in areas where there is no separate surface water sewerage system.

Foul sewers coloured brown may also carry surface water and there may be no separate surface water system indicated in the immediate area. Both combined and foul sewers carry wastewater to our treatment works before it can safely be returned to the environment.

Surface water sewers coloured blue on our drawings are intended only to carry uncontaminated surface water (e.g. rainfall from roofs, etc) and they usually discharge into local watercourses. It is important for the protection of the environment and water quality that only uncontaminated surface water is connected to the surface water sewers. Improper connections to surface water sewers from sink wastes, washing machines and other domestic use of water can cause significant pollution of watercourses.

Pumped mains, rising mains and sludge mains will all be subject to pumping pressures and are neither suitable nor available for making new connections.

Highway drains, when included, show as blue and black dashed lines. Highway drains are not assets belonging to United Utilities and are the responsibility of local authorities.

1. For information regarding future proposals for construction of company apparatus please write to United Utilities, PO Box 453, Warrington, WA5 3QN.
2. For information regarding easements, deeds, grants or wayleaves please write to United Utilities Property Solutions, Coniston Buildings, Lingley Mere Business Park, Lingley Green Avenue, Great Sankey, Warrington WA5 3UU (Tel: 01925 731 365).